


DART

DESIGN	DRAWN BY	DART AEROSPACE LTD HAWKESBURY, ONTARIO, CANADA		
JB	RT	DRAWING NO.	D2161	REV. B
CHECKED KE	APPROVED RT	TITLE	MIRROR BRACKET	SHEET 1 OF 1
DATE 99.06.07		SCALE	NTS	
A	93.04.29	NEW ISSUE		
B	99.06.07	REDRAWN FOR CLARITY ADDED -204/-205/-212 DESIGNATIONS		
B1	02.03.25	CHANGE FINISH		
B2	02.06.14	D2037-101 WELD		

RELEASED
KE 99.06.10

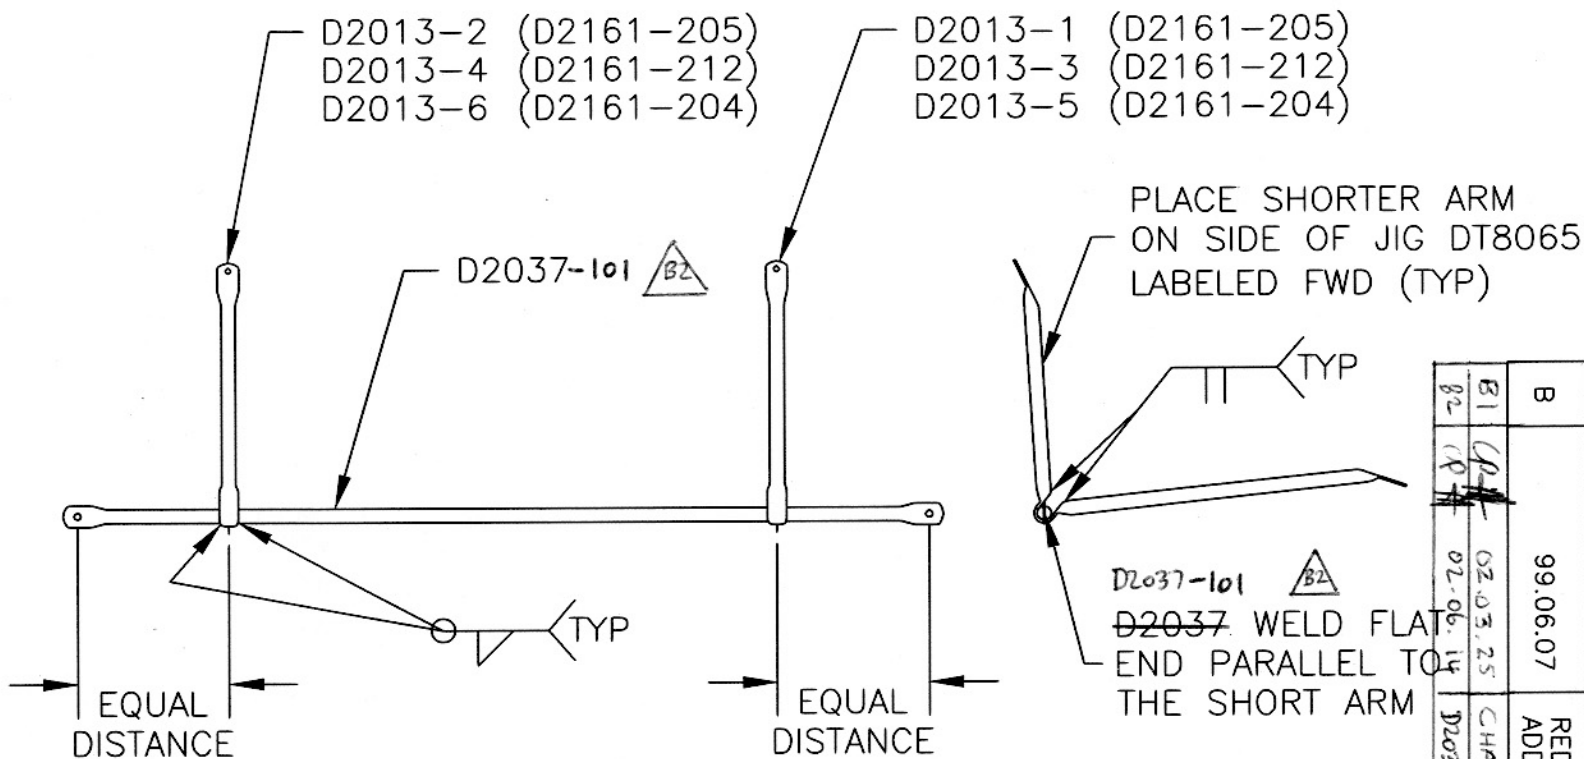

DETAIL OF D2161-204
DETAIL OF D2161-205
DETAIL OF D2161-212

NOTE: WELD ASSEMBLY
USING JIG DT8065

FINISH: ~~POWDER COAT ASSEMBLY BLACK~~
~~CRINKLE (4.3.5.3) PER DART QSI 005 4.3~~
~~POWDER COAT BLACK SANDTEX (4.3.5.7) PER~~
~~DART QSI 005 4.3~~ B1